


For Secretary of State Use Only

I CERTIFY THAT THIS PLAN HAS BEEN PREPARED IN CONFORMITY WITH THE REQUIREMENTS OF THE REGISTRATION ACT OF THE COMMONWEALTH OF MASSACHUSETTS.

John J. O'Brien
DATE: 11/1/79 REGISTERED LAND SURVEYOR

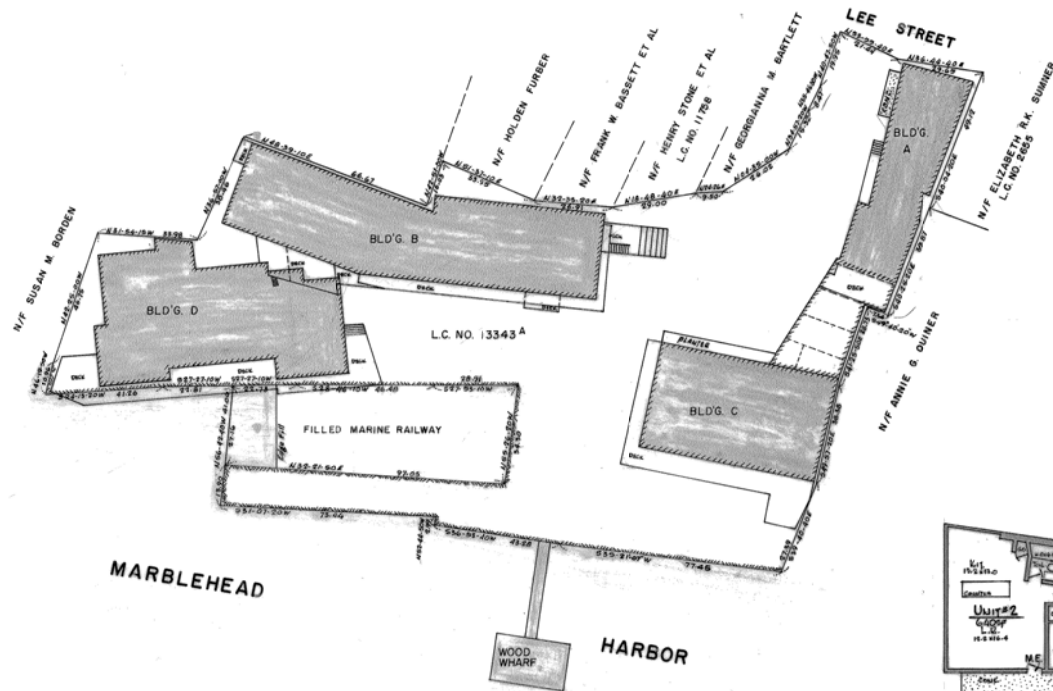

SITE PLAN

Scale = 1" = 20'-0"




NOTE:
LOT DIMENSIONS TAKEN FROM LAND COURT
PLAN NO. 13343A.

"Qualify this plan fully and accurately depict the layout, location, unit number and dimensions of the units."

Numbered 1 through 10


Including in the boundary as built.

Date: 11/1/79 Signed: *John J. O'Brien*

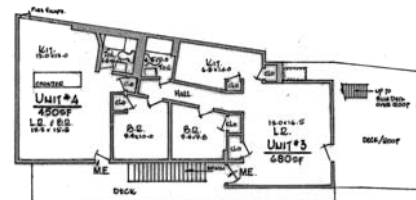

SECOND FLOOR, BUILDING A:

Scale: 1" = 10'-0"

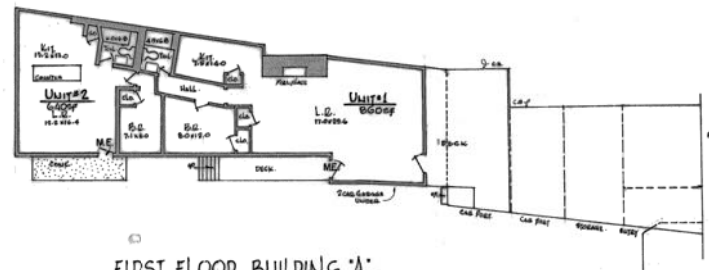

FIRST FLOOR, BUILDING A:


Scale: 1" = 10'-0"

**PLAN OF HARBORSIDE
CONDOMINIUMS
MARBLEHEAD, MASS.**

SCALE: AS SHOWN NOV. 1979
CARTER & TOWERS ENGINEERING CORP
SWAMPSCOTT, MASS.




M.E. MAIN ENTRANCE

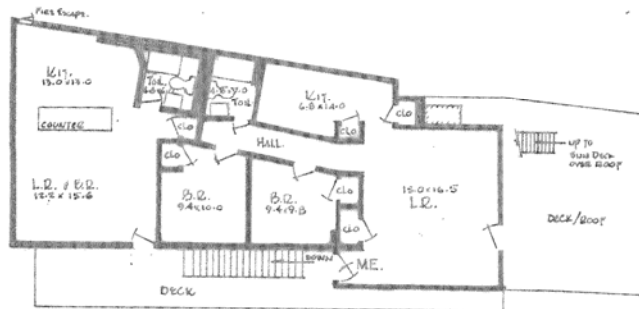

UNIT 3 - 1,130 ± SF


SECOND FLOOR, BUILDING "A":

Scale: 1" = 10'-0"

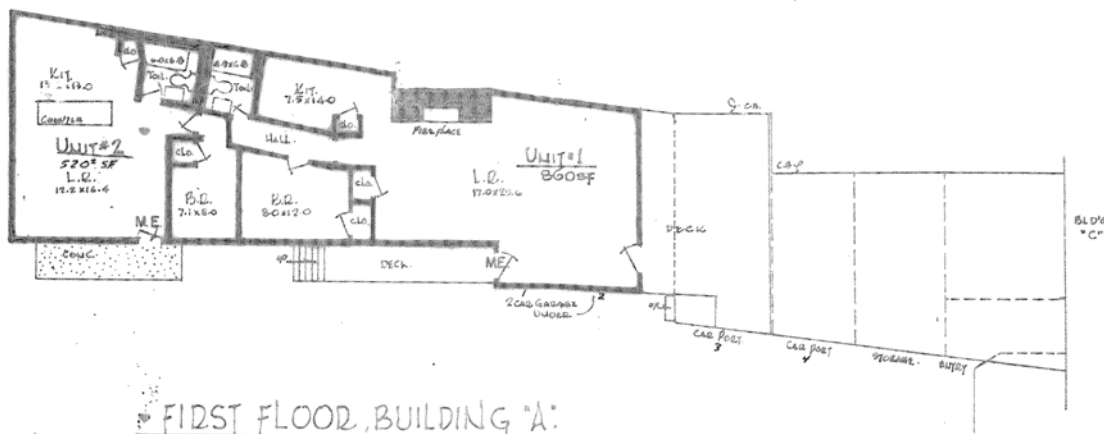

FIRST FLOOR, BUILDING "A":

Scale: 1" = 10'-0"

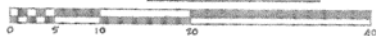

"I certify that this plan fully and accurately depicts the layout, location, unit number and dimensions of the units


numbered 1 through 3
inclusive, in BUILDING A
as built."

Date 11/3/79 Signed Joseph D. Carter

M.E. = MAIN ENTRANCE


I CERTIFY THAT THIS PLAN HAS BEEN PREPARED IN CONFORMITY WITH THE RULES AND REGULATIONS OF THE REGISTERS OF DEEDS OF THE COMMONWEALTH OF MASSACHUSETTS.

11/3/79
DATE Joseph D. Carter
REGISTERED LAND SURVEYOR

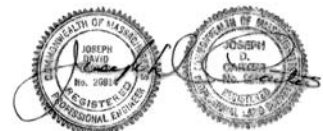


AMENDED PLAN OF HARBORSIDE CONDOMINIUMS MARBLEHEAD, MASS.


SCALE: AS SHOWN NOV 1979
CARTER & TOWERS ENGINEERING CORP.
SWAMPSCOTT, MASS.

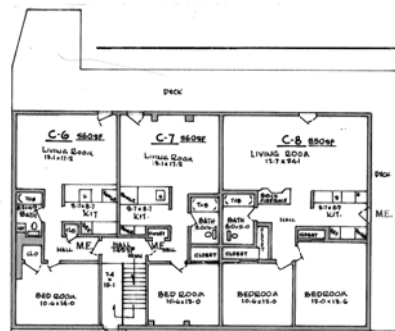


2ND FLOOR
BLDG-C

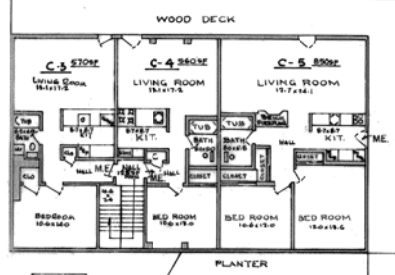


1ST FLOOR
BLDG-C

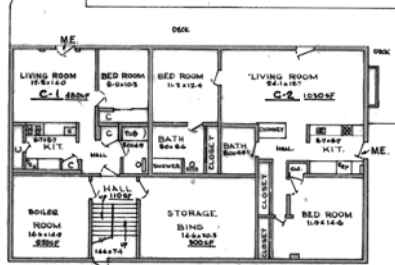


GROUND FLOOR
GROUND LEVEL
BLDG-C

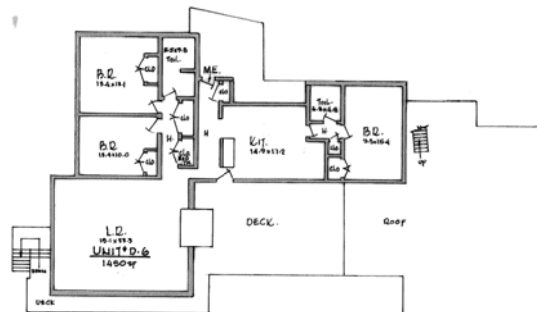


BLDG-D, 3RD LEVEL
Scale: 1"=10'-0"

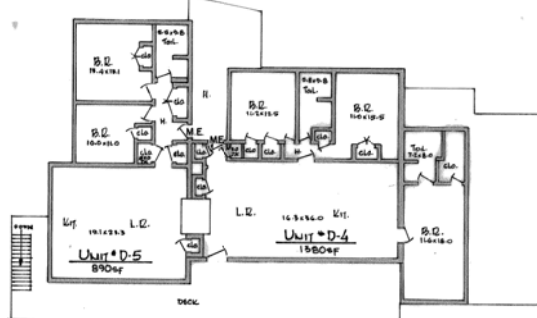


BLDG-D, 2ND LEVEL
Scale: 1"=10'-0"

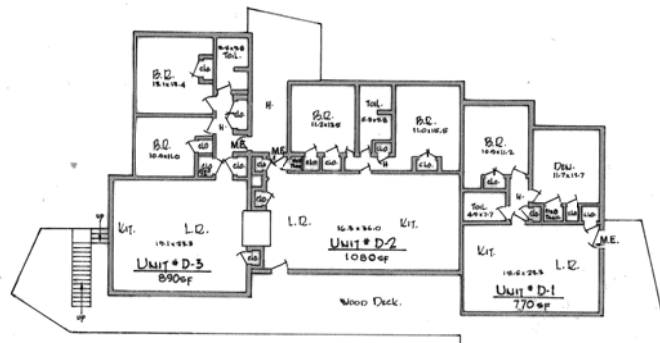


BLDG-D, 1ST LEVEL
Scale: 1"=10'-0"

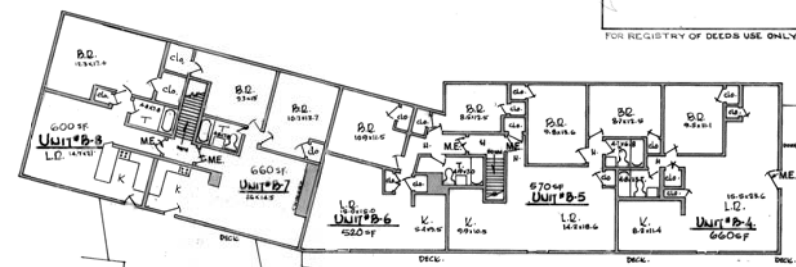

THIRD LEVEL BLDG-B
Scale: 1"=10'-0"

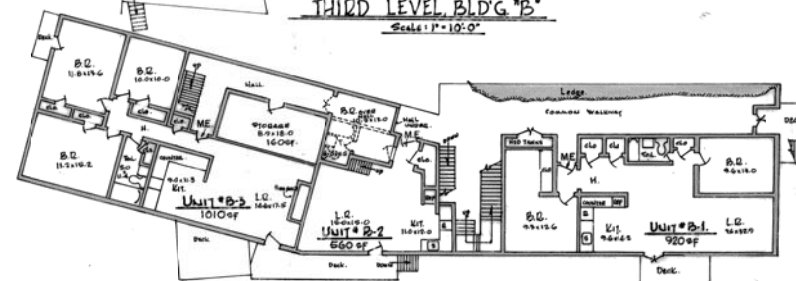

SECOND LEVEL BLDG-B
Scale: 1"=10'-0"

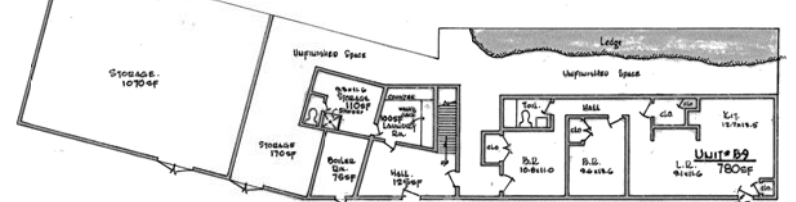

FIRST LEVEL BLDG-B
Scale: 1"=10'-0"


PLAN OF HARBORSIDE
CONDOMINIUMS
MARBLEHEAD, MASS.
SCALE: AS SHOWN NOV 1979
CARTER & TOWERS ENGINEERING CORP.
SWAMPSCOTT, MASS.

UNIT D-1 & D-2 EXISTING UNITS, FULL CT

ME = MAIN ENTRANCE


"I certify that this plan fully and accurately depicts the layout, location, unit number and dimensions of the area as built."

Drawn by *[Signature]* Signed *[Signature]*
Revised 5/1/86

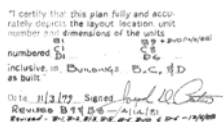


FOR REGISTRY USE
ONLY

SECOND AMENDED PLAN OF HARBORSIDE CONDOMINIUM

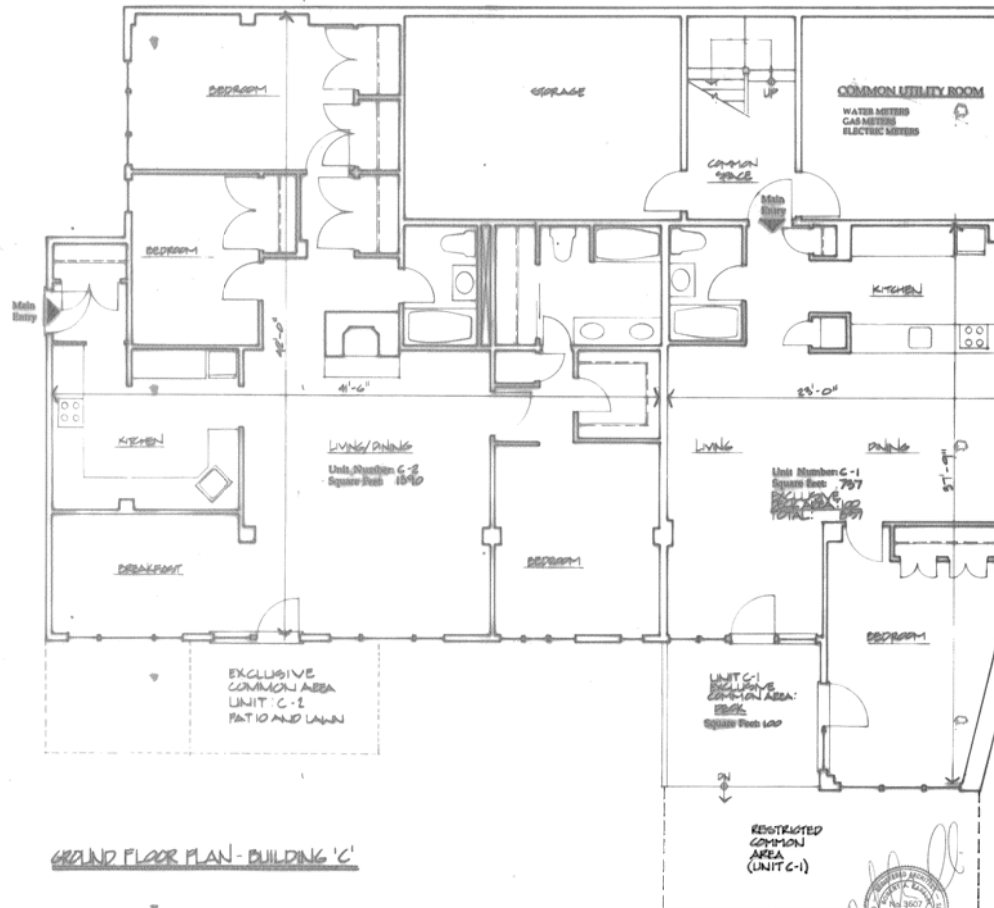

GROUND FLOOR PLAN - BUILDING 'C'

Notes
Unit areas include fireplaces within the unit as designated.
Unit areas do not include mechanical chase for utilities.
Ceiling heights vary throughout the building from 8'-11" to 9'-10".
Reasonable care has been taken by the architect to accurately represent the building as built. Small dimensional inconsistencies that exist due to the age of the building should not affect unit areas as designated.

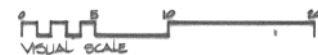

I hereby certify that this plan fully and accurately depicts the layout, location, unit number and dimensions of units as built in the condominium as built.

I hereby certify that this plan conforms to the rules and regulations of the Register of Deeds of Massachusetts.


CONDOMINIUMS LOCATED AT
24 LEE STREET
MARBLEHEAD, MA 01945

SCALE AND DATE 01/15

ROBERT ZARELLI ARCHITECT
69 WASHINGTON STREET MARBLEHEAD, MA 01945

PHOTOCOPY USE
ONLY

SECOND AMENDED PLAN OF HARBORSIDE CONDOMINIUM

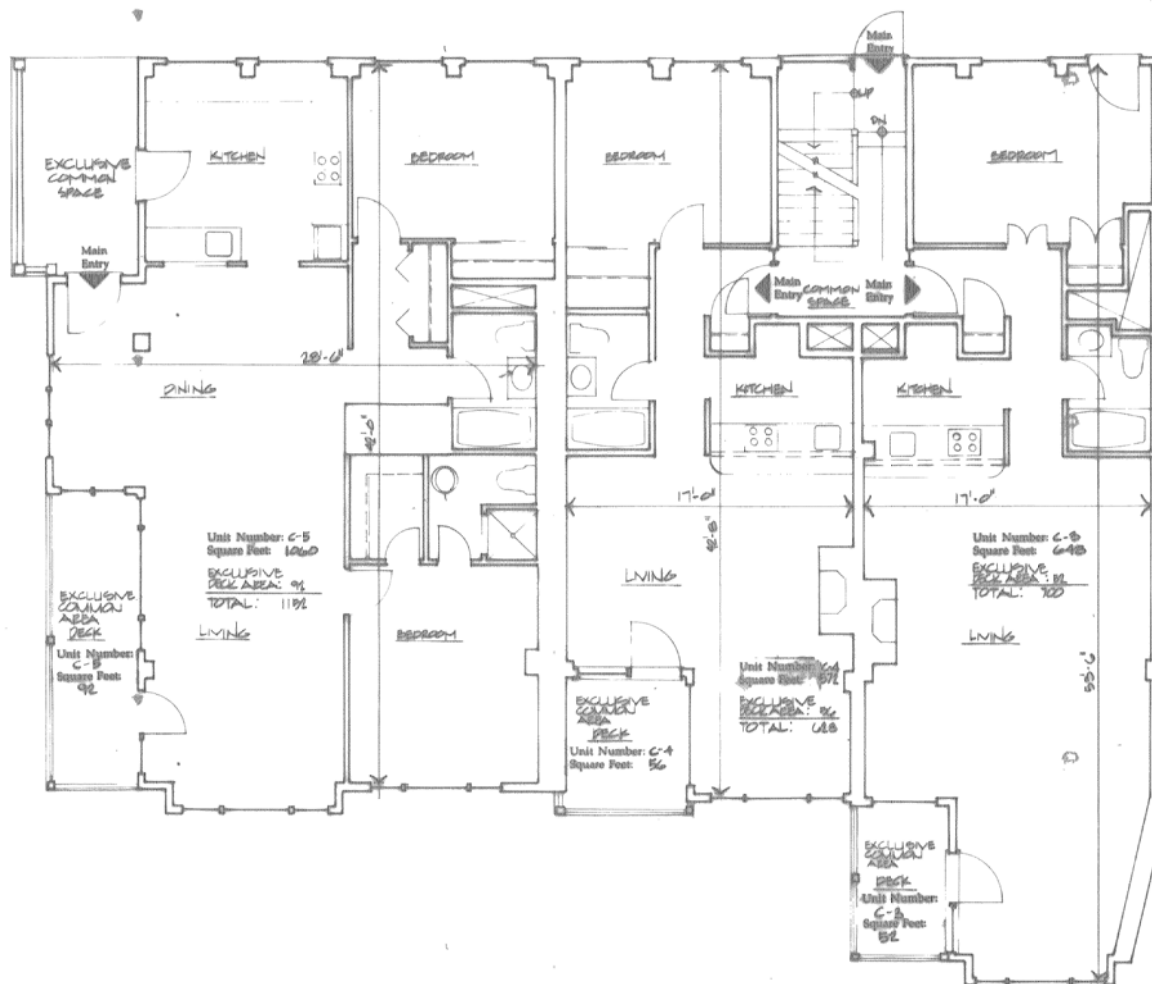

FIRST FLOOR PLAN - BUILDING 'C'

Notes

Unit areas include fireplaces within the unit as designated.

Unit areas do not include mechanical chases for utilities.

Ceiling heights vary throughout the building from 6'-11" to 8'-10".

Reasonable care has been taken by the architect to accurately represent the building as built. Small dimensional inconsistencies that exist due to the age of the building should not affect unit areas as designated.




I hereby certify that this plan fully and accurately depicts the layout, location, unit number and dimensions of units C-1, C-2, C-3, C-4, C-5 in the condominium as built.

I hereby certify that this plan conforms to the rules and regulations of the Register of Deeds of Massachusetts.



FOR REGISTRY USE
ONLY

SECOND AMENDED PLAN OF HARBORSIDE CONDOMINIUM

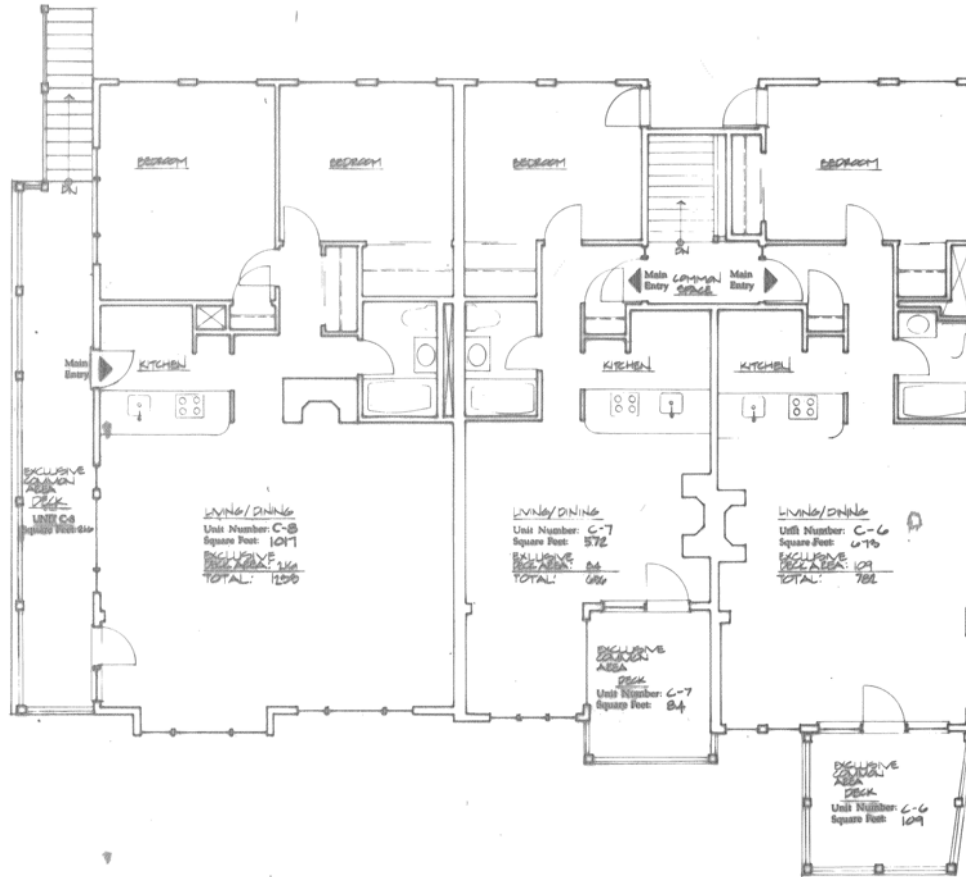

SECOND FLOOR PLAN - BUILDING 'C'



I hereby certify that this plan fully and accurately depicts the layout, location, unit number and dimensions of units Units C-6, C-7, C-8 located at 29 Lee Street, Marblehead, Massachusetts as built.

I hereby certify that this plan conforms to the rules and regulations of the Register of Deeds of Massachusetts.

Notes:
Unit areas include fireplaces within the unit as designated.
Unit areas do not include mechanical chases for utilities.
Ceiling heights vary throughout the building from 6'-11" to 8'-10".
Reasonable care has been taken by the architect to accurately represent the building as built. Small dimensional inconsistencies that exist due to the age of the building should not affect unit areas as designated.


CONDOMINIUMS LOCATED AT
24 LEE STREET
MARBLEHEAD, MA 01945

SCALE: 1/4" = 1'-0"

ROBERT ZARELLI ARCHITECT
69 WASHINGTON STREET MARBLEHEAD, MA 01945

FOR REGISTRY USE
ONLY

SECOND AMENDED PLAN OF HARBORSIDE CONDOMINIUM

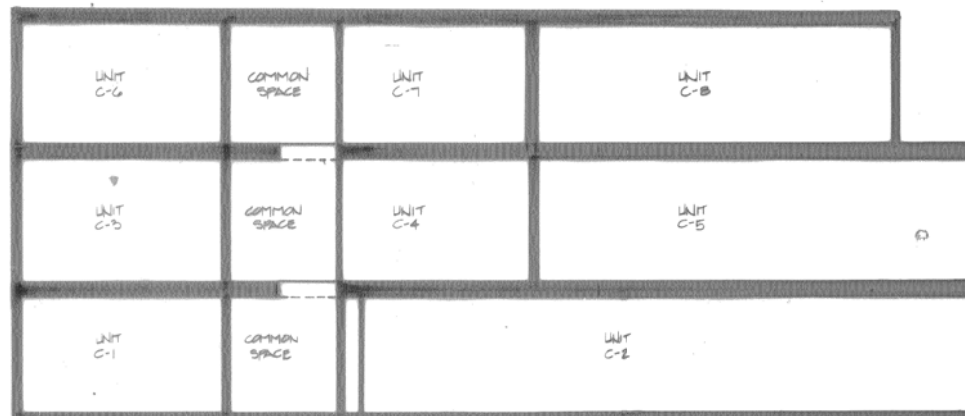

DIAGRAMMATIC LATERAL SECTION



VISUAL SCALE
I hereby certify that this plan fully and accurately depicts the layout, location, unit number and dimensions of units C-1 to C-8, located at 24 Lee Street, Marblehead, Massachusetts as built.

I hereby certify that this plan conforms to the rules and regulations of the Register of Deeds of Massachusetts.

Notes
Unit areas include fireplaces within the unit as designated.
Unit areas do not include mechanical chases for utilities.
Ceiling heights vary throughout the building from 6'-11" to 8'-10".
Reasonable care has been taken by the architect to accurately represent the building as built. Small dimensional inconsistencies that exist due to the age of the building should not affect unit areas as designated.

CONDOMINIUMS LOCATED AT
24 LEE STREET
MARBLEHEAD, MA 01945

SCALE:	DATE: 10/1/15
--------	---------------

ROBERT ZARELLI ARCHITECT
69 WASHINGTON STREET MARBLEHEAD, MA 01945

CONDOMINIUM


MODIFICATION PLAN OF LAND IN MARBLEHEAD

Carter & Towers Engineering Corp., Surveyors

March 25, 1981

13343C-1

Essex South Registry District
October 26, 1983
RECEIVED AND FILED
With Certificate No. C 23

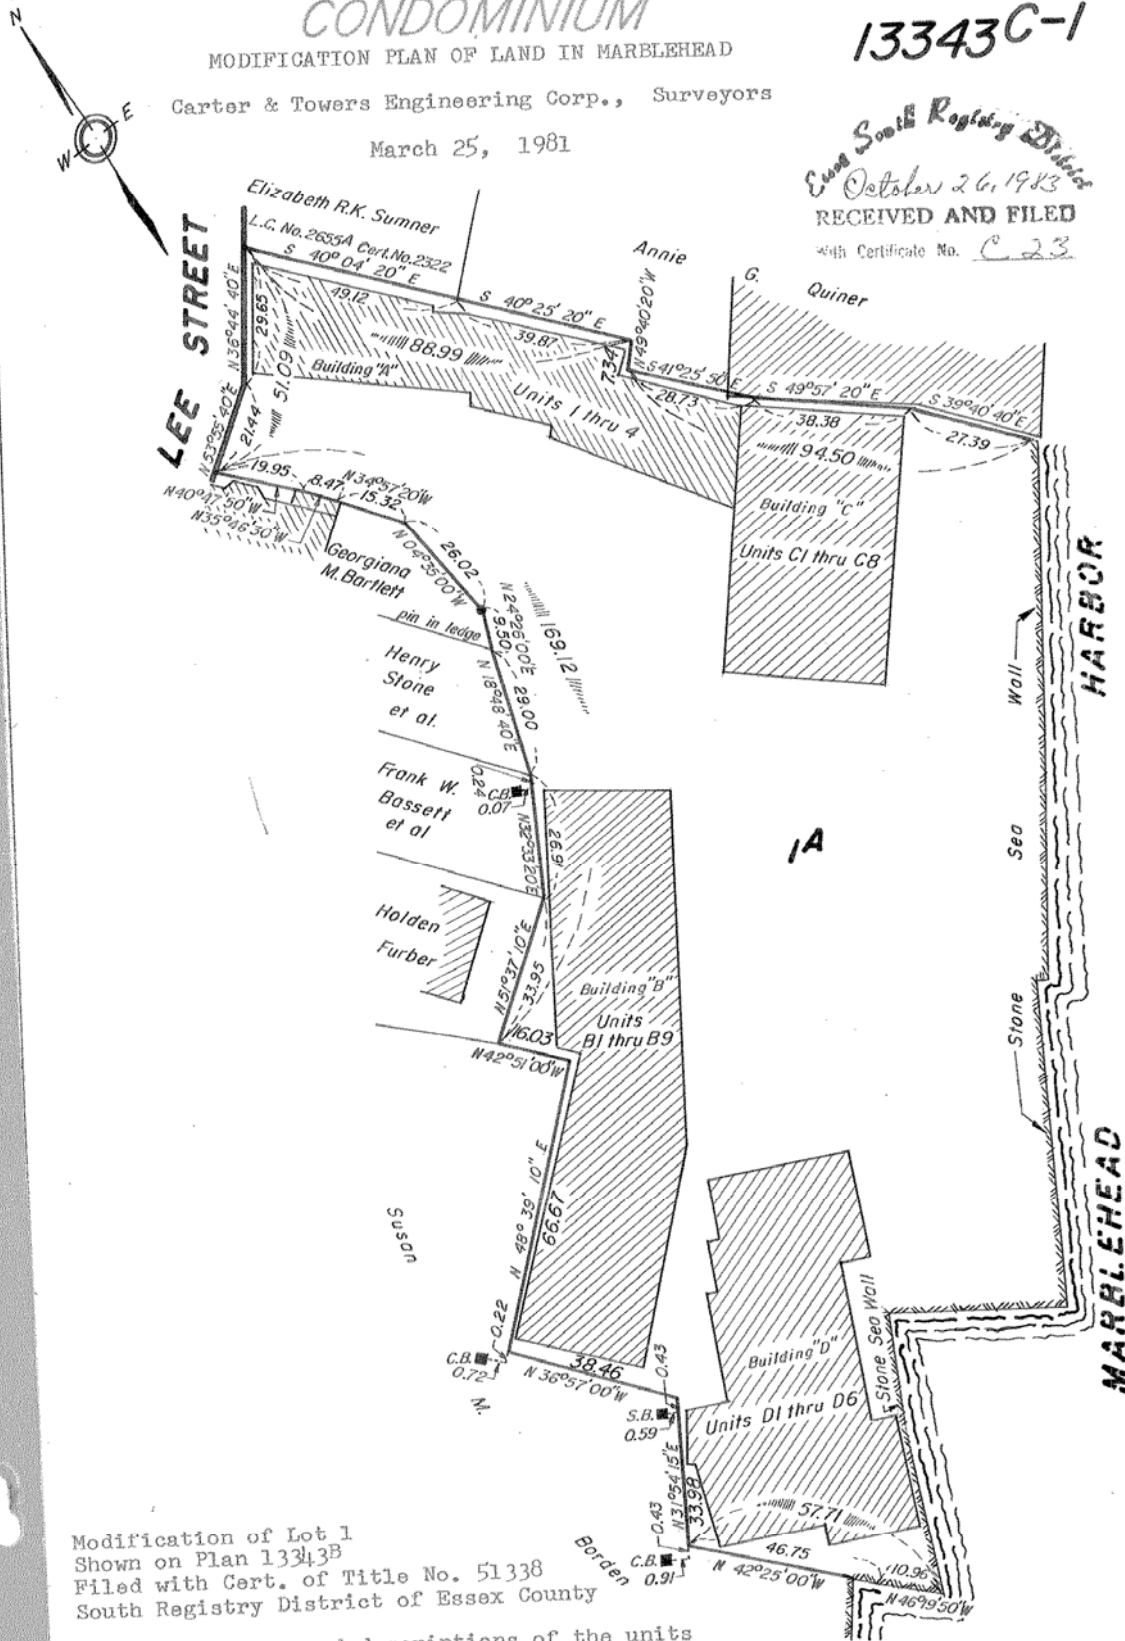

Modification of Lot 1
Shown on Plan 13343B
Filed with Cert. of Title No. 51338
South Registry District of Essex County

For more details and descriptions of the units hereon see plans and deeds on file in the registered land section of the Registry of Deeds and noted on the Master Condominium Certificate issued referring to this plan.

Abutters are shown as on original decree plan

Copy of part of plan
filed in
LAND REGISTRATION OFFICE
OCT. 25, 1983
Scale of this plan 30 feet to an inch
Louis A. Moore, Engineer for Court

By the Court

OCT. 25, 1983.

Form LCE-D-2, 1500 3-84

James N. Maloney
Registry Recorder